
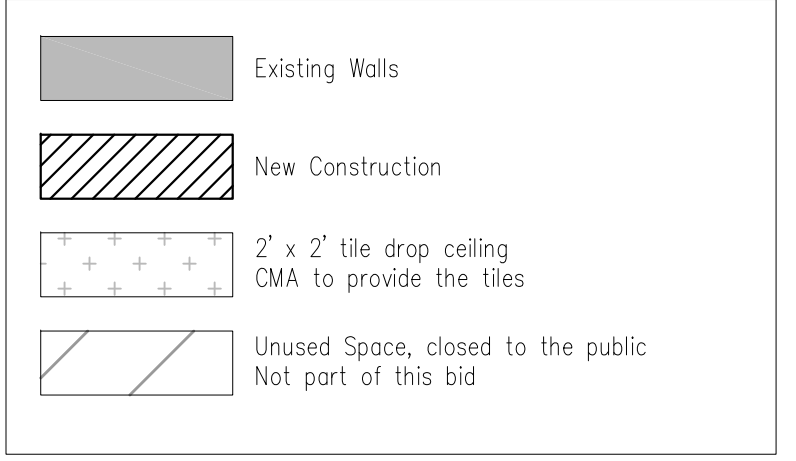


ISSUED / REVISED		
NO.	DATE:	DESCRIPTION

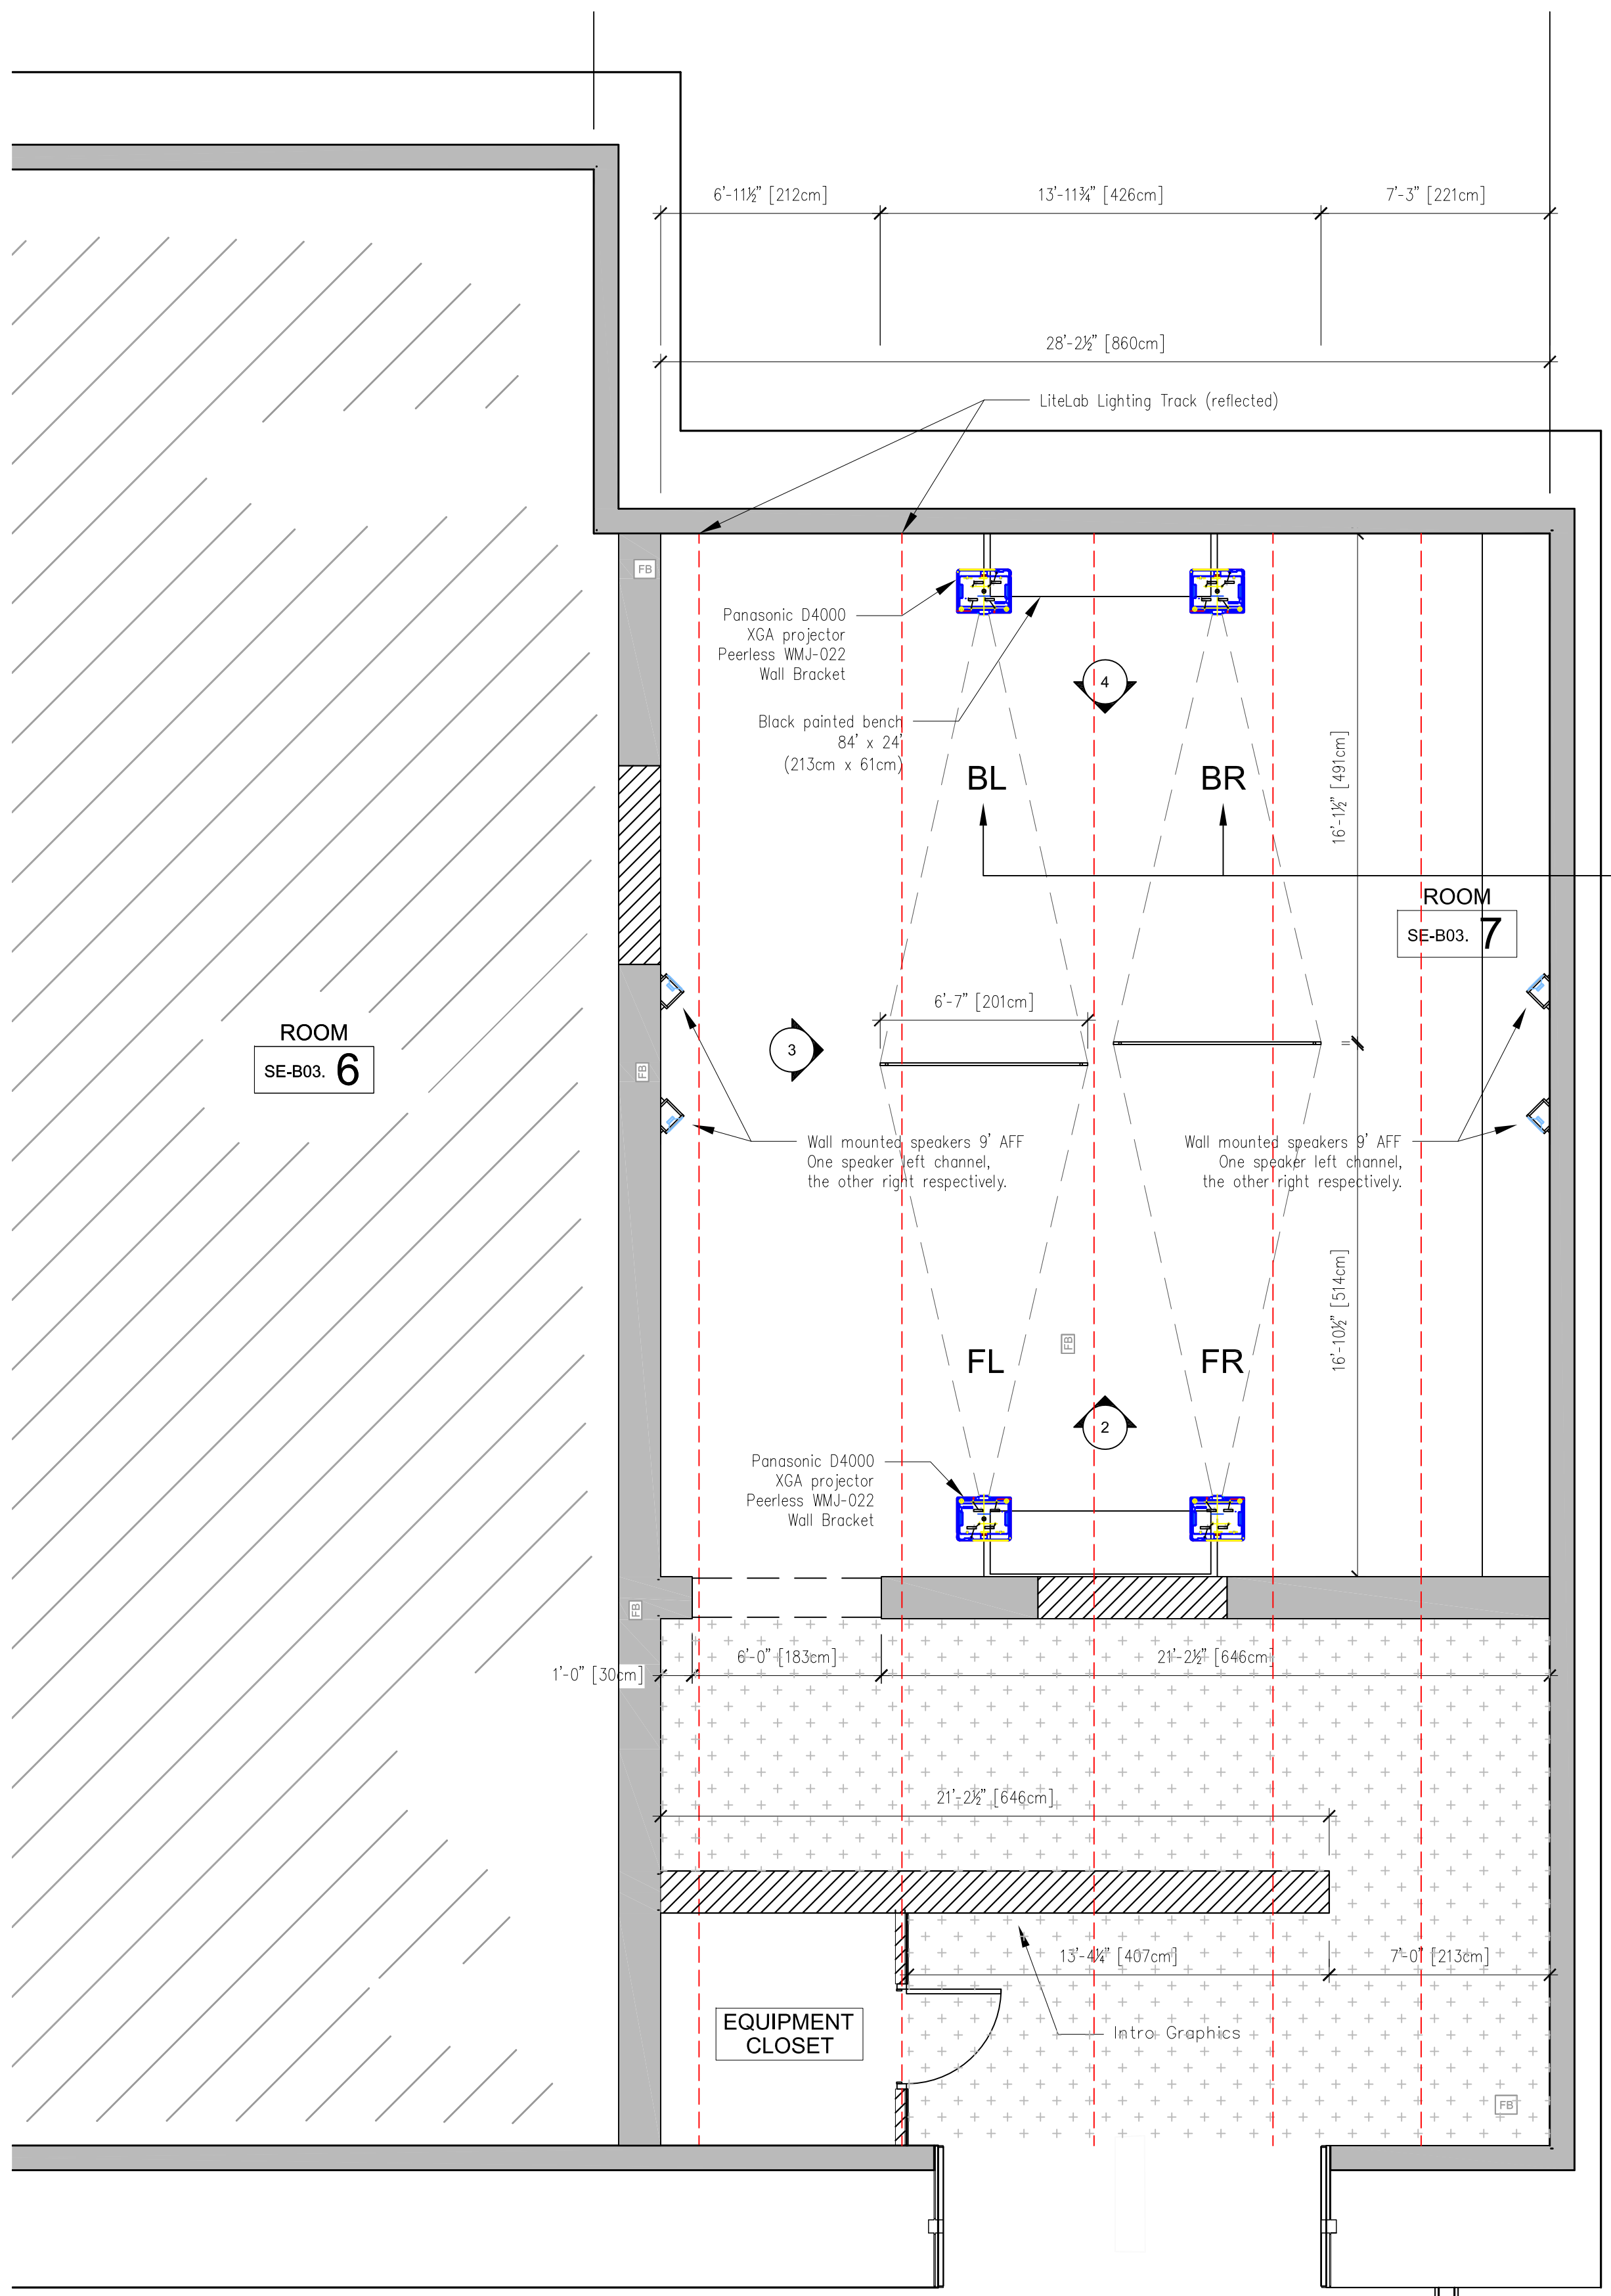


1 Gallery Plan View  
1/4" = 1'


At the request of Omer Fast:  
BR & BL projector set to "Rear projection"  
to flip the images from the provided video

When viewed from the rear:  
Video of Omer Fast should be on the Right  
and flipped (mirror image of supplied video)

Video of Army Sergeant should be on the Left  
and flipped (mirror image of supplied video)

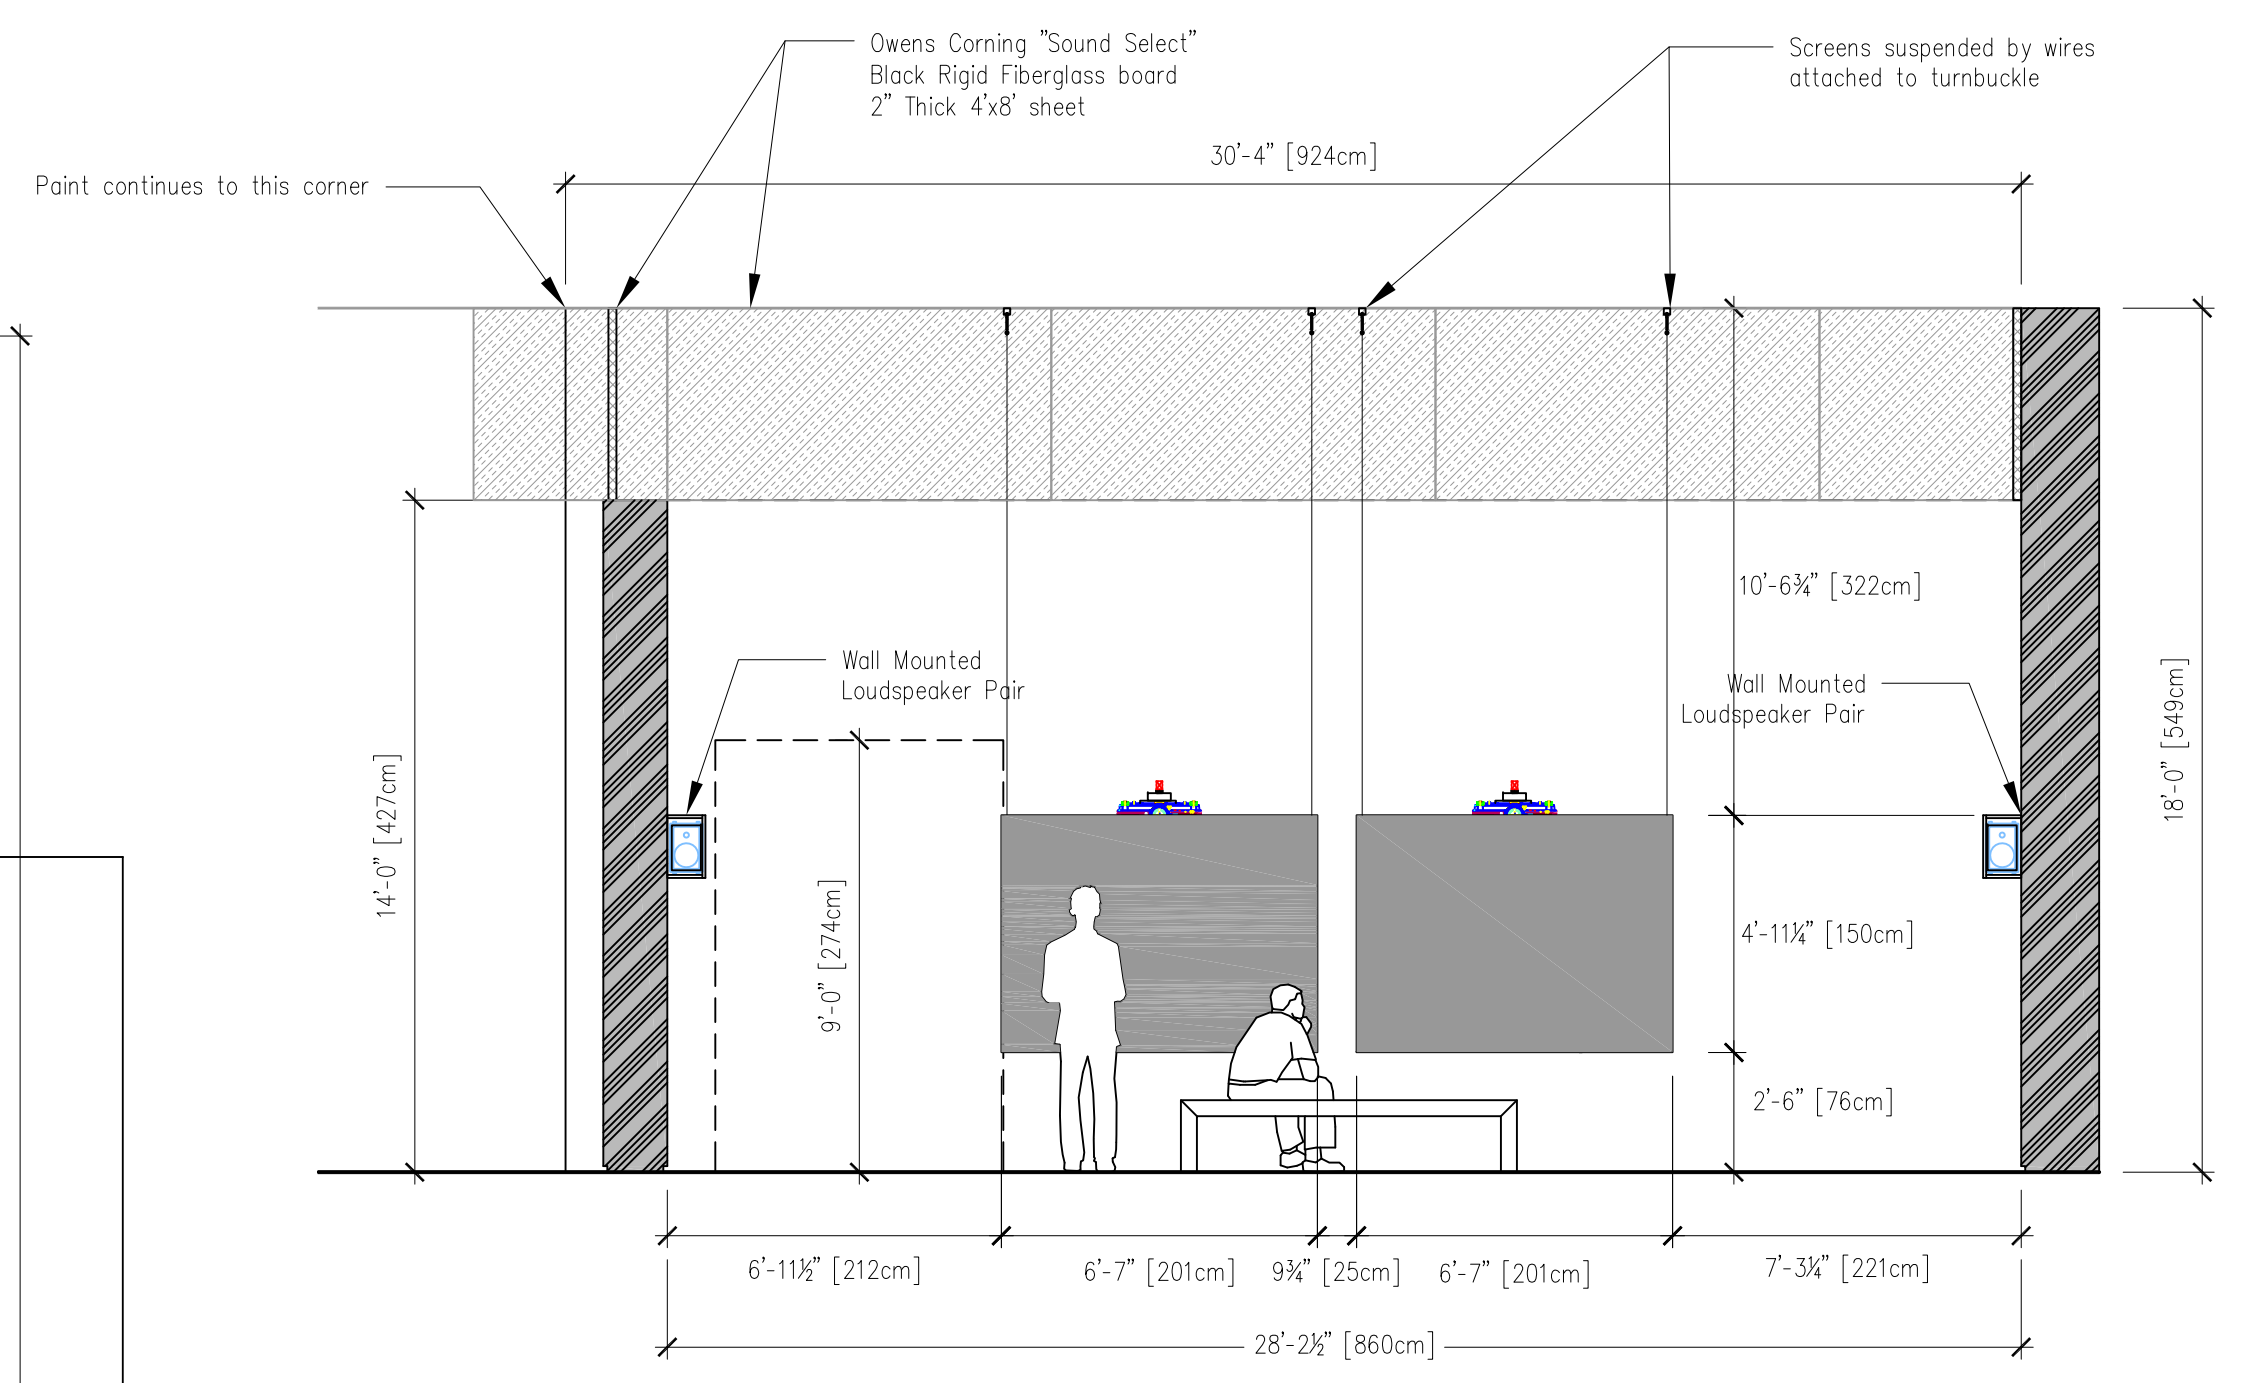

2 Gallery Section / East Elevation  
1/4" = 1'

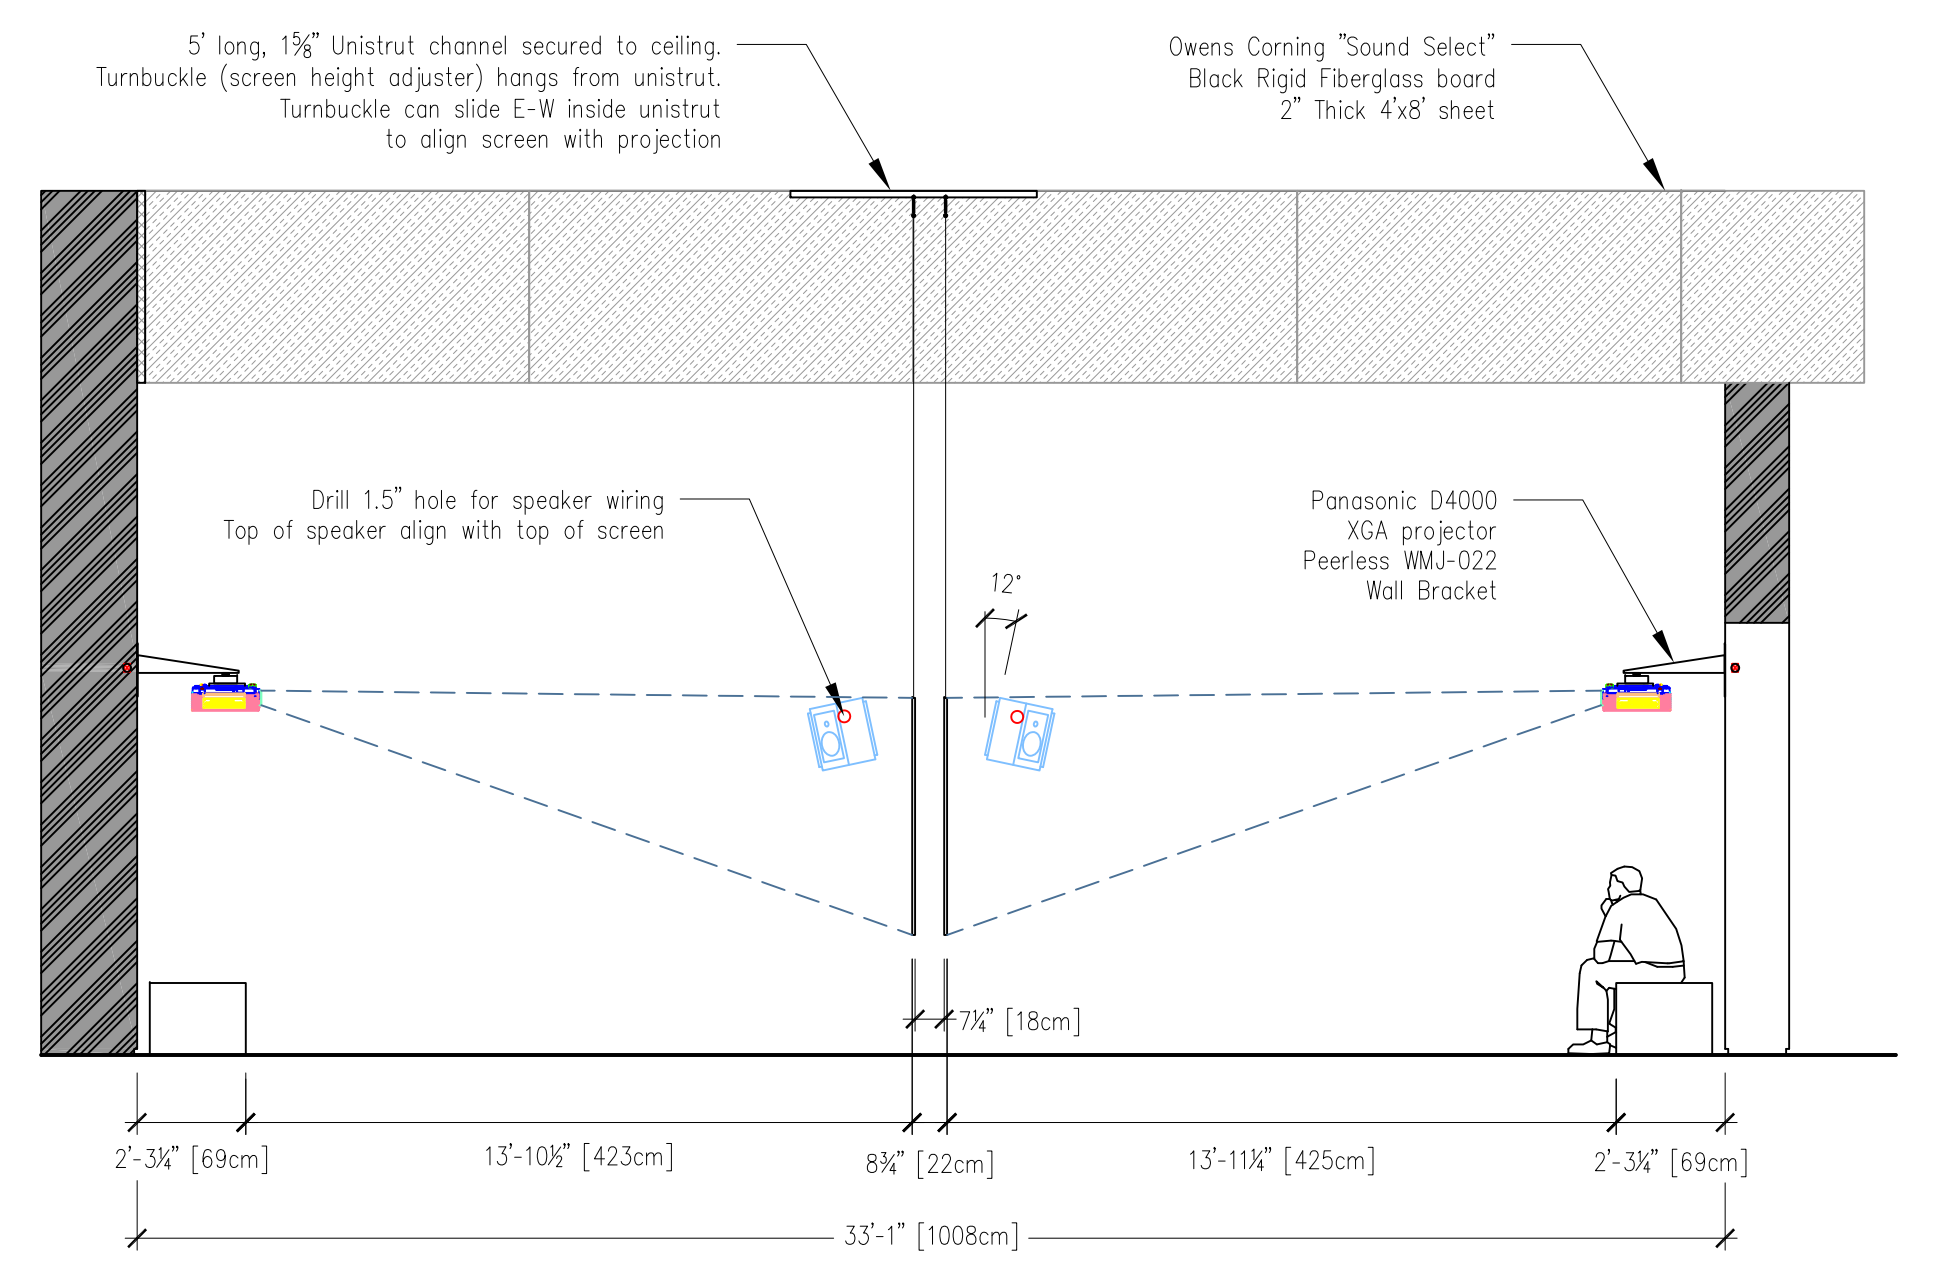

3 Gallery Section / South Elevation  
1/4" = 1'



2 Installation Photograph - East View  
NTS



4 Installation Photograph - West View  
NTS

**THE CLEVELAND MUSEUM OF ART**

The Cleveland Museum of Art  
Design and Architecture Department  
11150 East Boulevard,  
Cleveland, Ohio 44106-1797  
T 216-707-2401 F 216-707-6687

PROJECT:  
**Omer Fast  
"The Casting"**

DRAWING CONTENTS:  
**Installation Plan  
As Built**

DRAWN BY: J. Engelman DATE: 05/11/2010  
SCALE: 1/4" = 1'  
SHEET NO.